
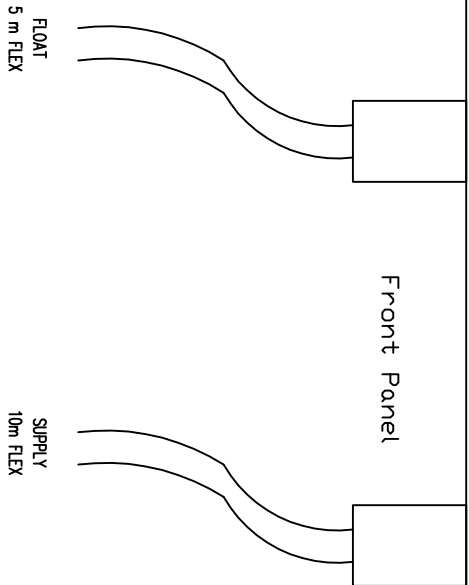
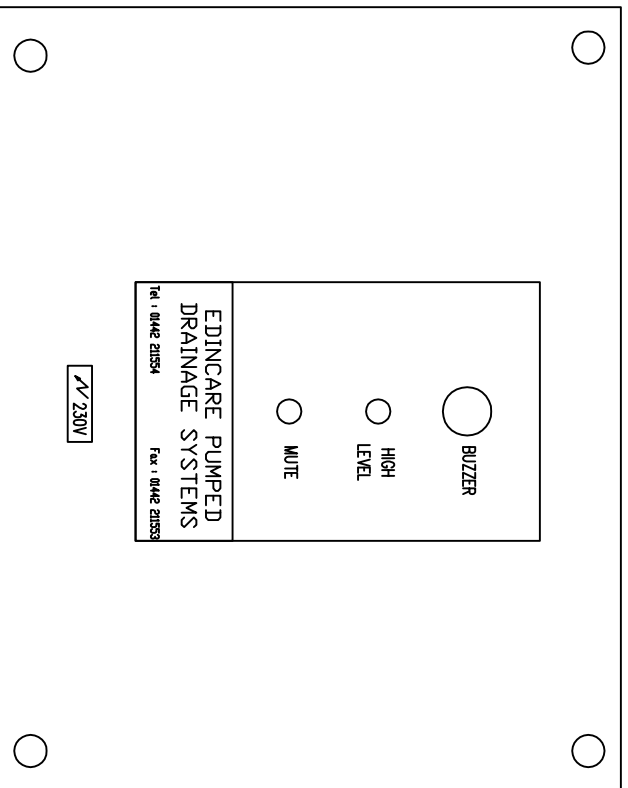


1	2	3	4	5	6	7	8																																
Issue		Revision		Sheet		By		Date																															
0		As Built		1-3		RJW		15/08/07																															
A				B				C				D				E				F				G				H				I				J			
Iss		Description		Date		Scale		[Not to Scale]		Title		Drawing Number		Sheet																									
1		As Built		15/08/07		Drawn		RJW		Pump Station Control Panel		Battery Backed High Level Alarm Module		2																									
2						Date		15/08/07		Project Control Sheet		WEP10476-A		2																									
3						Checked		WDW																															
4																																							
5										EDINCARE Pumped Drainage Systems Unit 10 Avebury Court, Mark Road, Hemel Hempsted Herts, HP2 7TA Tel: 01442 211554 Fax: 01442 211553				3																									
				<p style="text-align: center;"><u>Cable Colours</u></p> <table border="0"> <tr><td>415VAC L1</td><td>Brown</td></tr> <tr><td>415VAC L2</td><td>Black</td></tr> <tr><td>415VAC L3</td><td>Grey</td></tr> <tr><td>415VAC N</td><td>Blue</td></tr> <tr><td>240VAC L</td><td>Brown</td></tr> <tr><td>240VAC N</td><td>Blue</td></tr> <tr><td>110VAC L</td><td>-</td></tr> <tr><td>110VAC N</td><td>-</td></tr> <tr><td>24VAC L</td><td>White</td></tr> <tr><td>24VAC N</td><td>Orange</td></tr> <tr><td>24VDC +</td><td>Dark Blue</td></tr> <tr><td>24VDC -</td><td>Dark Blue</td></tr> </table>				415VAC L1	Brown	415VAC L2	Black	415VAC L3	Grey	415VAC N	Blue	240VAC L	Brown	240VAC N	Blue	110VAC L	-	110VAC N	-	24VAC L	White	24VAC N	Orange	24VDC +	Dark Blue	24VDC -	Dark Blue								
415VAC L1	Brown																																						
415VAC L2	Black																																						
415VAC L3	Grey																																						
415VAC N	Blue																																						
240VAC L	Brown																																						
240VAC N	Blue																																						
110VAC L	-																																						
110VAC N	-																																						
24VAC L	White																																						
24VAC N	Orange																																						
24VDC +	Dark Blue																																						
24VDC -	Dark Blue																																						
				<p style="text-align: center;"><u>Miscellaneous</u></p> <table border="0"> <tr><td>Ammeters</td><td>Violet</td></tr> <tr><td>4-20mA</td><td>Violet</td></tr> </table>				Ammeters	Violet	4-20mA	Violet																												
Ammeters	Violet																																						
4-20mA	Violet																																						
				<p style="text-align: center;"><u>Drawing Control Notes</u></p> <table border="0"> <tr><td>Arrangement Drawing</td><td>2</td></tr> <tr><td>Wiring Schematic</td><td>3</td></tr> </table>				Arrangement Drawing	2	Wiring Schematic	3																												
Arrangement Drawing	2																																						
Wiring Schematic	3																																						

POLYCARBONATE ENCLOSURE  
250-mm x 200mm x 90mm

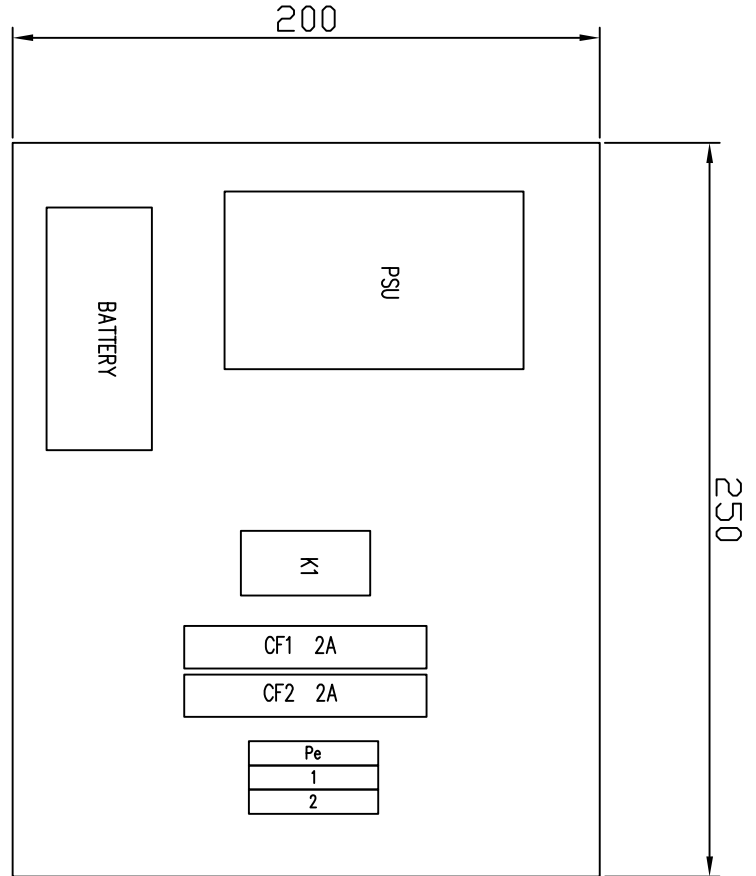

Iss	Description	Date	Scale	[Not to Scale]	Title	Drawing Number	Sheet
1	As Built	15/08/07	Drawn	RJ	Pump Station Control Panel	Battery Backed High Level Alarm Module	2
2			Date	15/08/07	General Arrangement		
3			Checked	WDW			
4							
5					EDINCARE Pumped Drainage Systems Unit 10 Avebury Court, Mark Road, Hemel Hempsted Herts, HP2 7TA Tel : 01442 21554 Fax : 01442 21553	WEPI0476-A	of 3

J

I

H

G

F

E


D

C

B

A

1 2 3 4 5 6 7 8

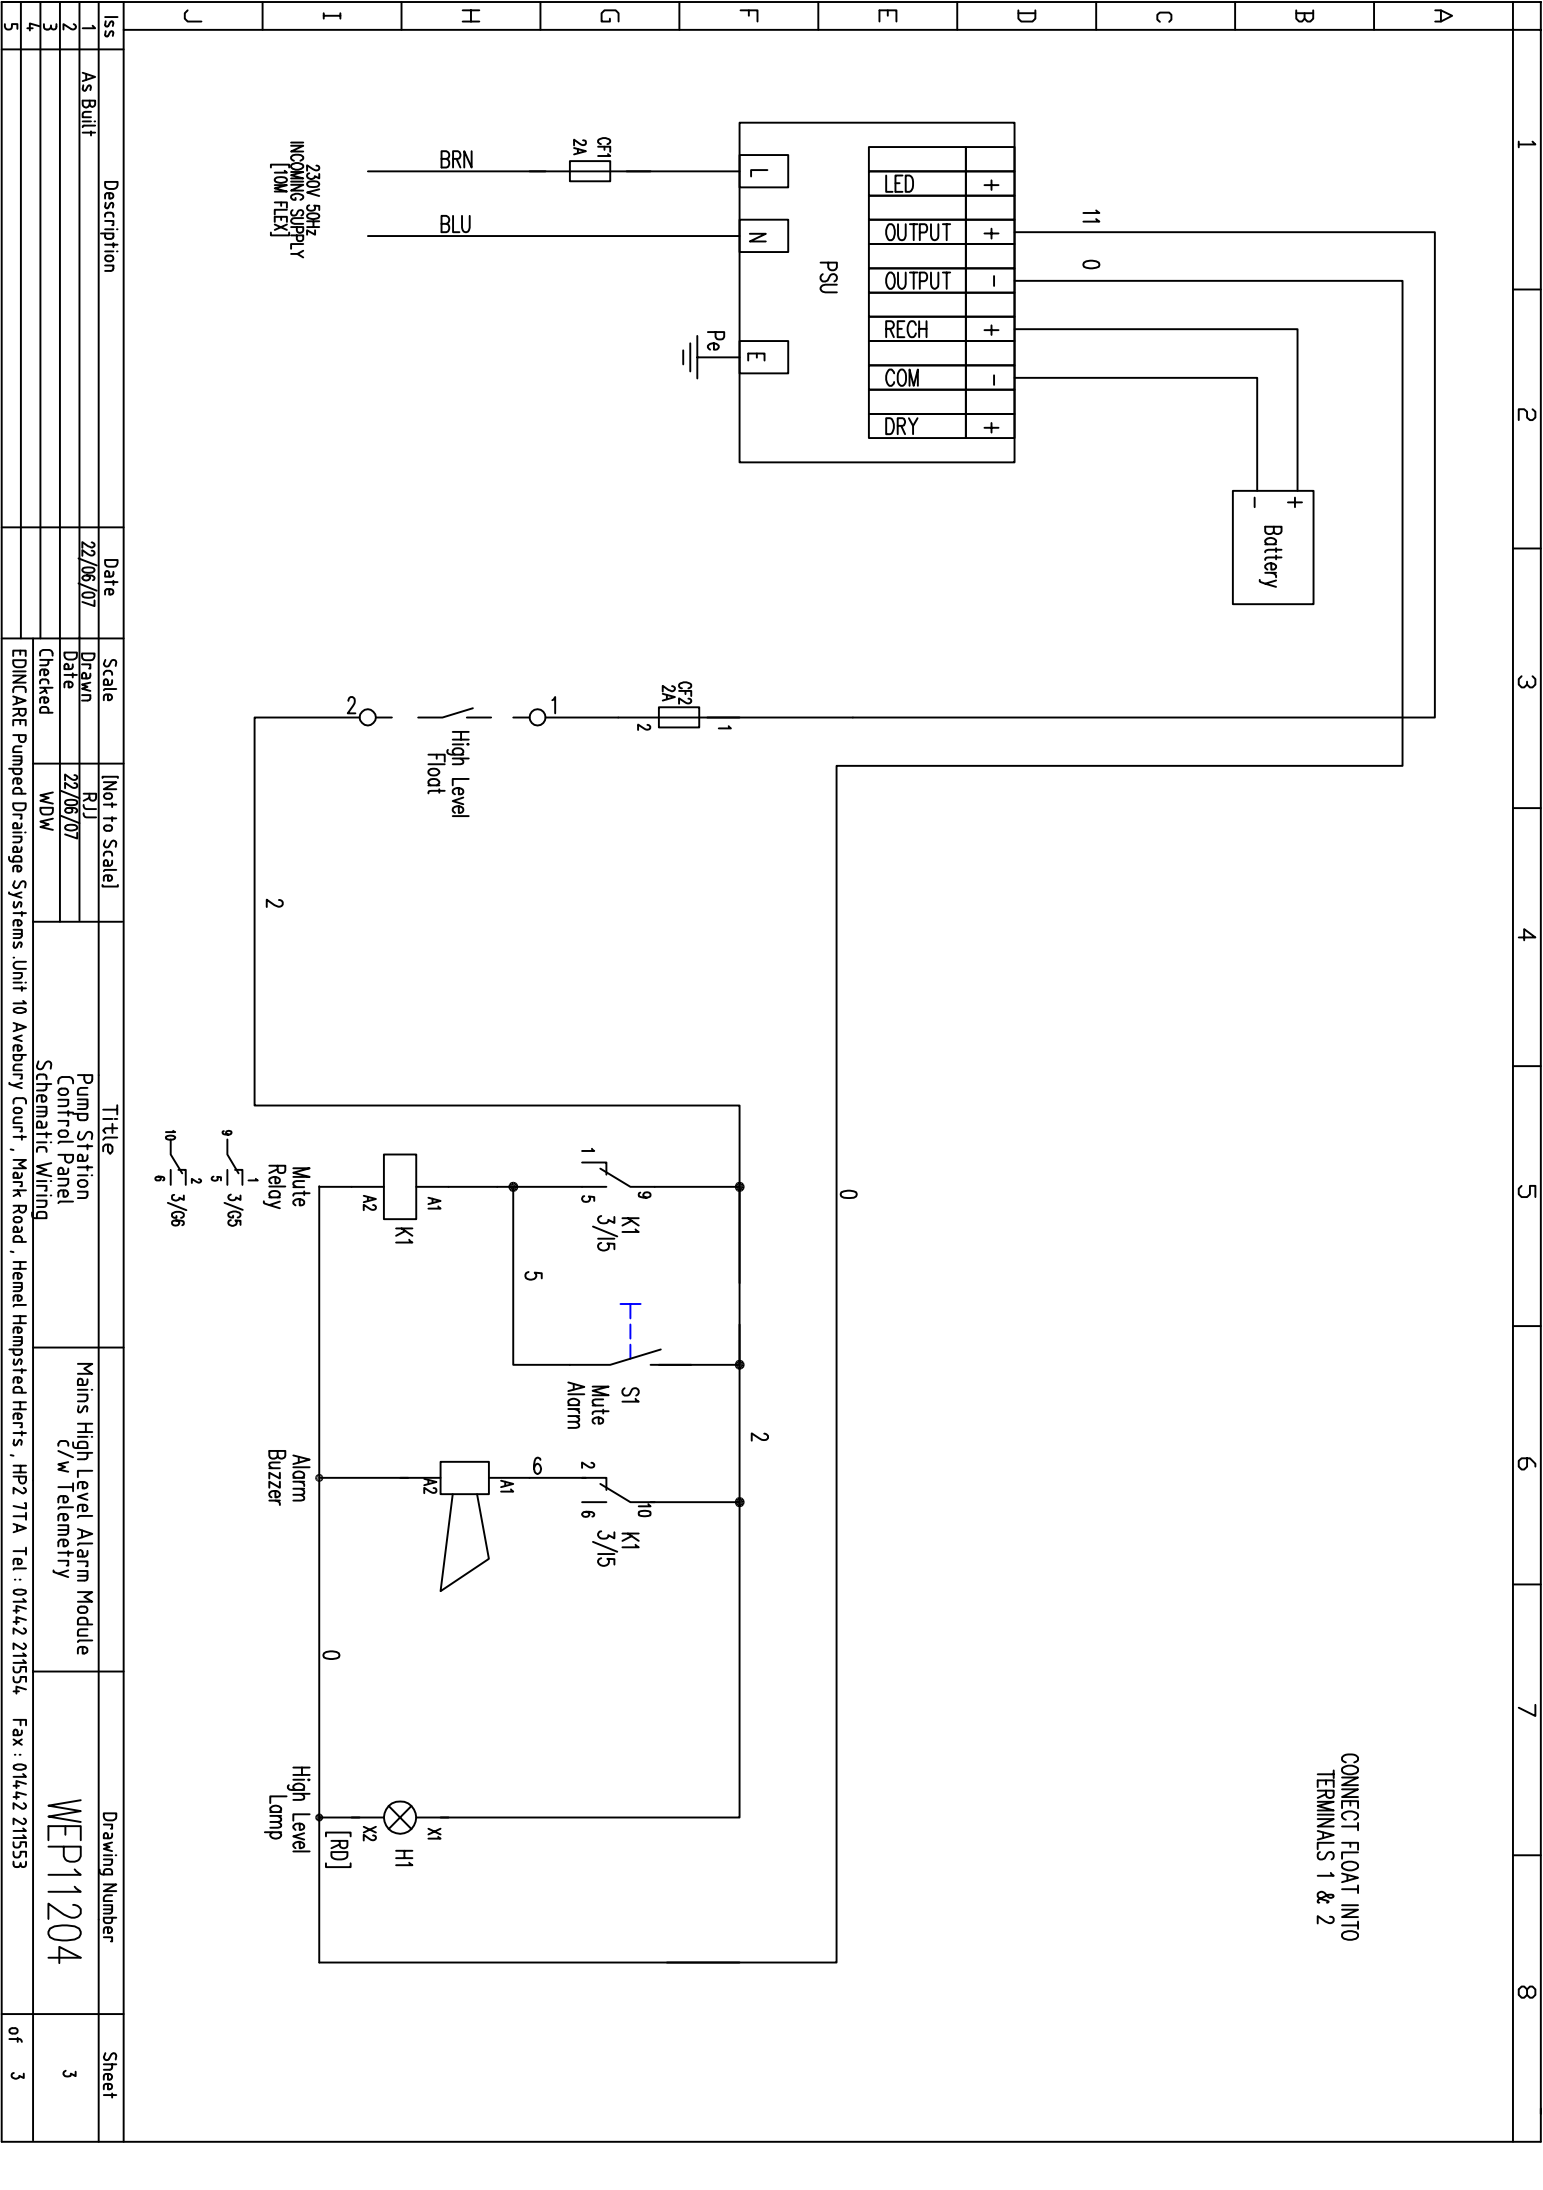

CONNECT FLOAT INTO  
TERMINALS 1 & 2

Iss	Description	Date	Scale	[Not to Scale]	Title	Mains High Level Alarm Module	Drawing Number	Sheet
1	As Built	22/06/07	Drawn	RJ	Pump Station Control Panel	C/w Telemetry	WEP11204	3
2			Date	WDW	Schematic Wiring			
3			Checked					
4								
5					EDINCARE Pumped Drainage Systems Unit 10 Avebury Court, Mark Road, Hemel Hempsted Herts, HP2 7TA Tel: 01442 211554 Fax: 01442 211553			of 3